


LEGEND:

- ASPH = asphalt
- BRG = bearing
- BLDG = building
- CALC = calculated
- CAP = capped iron
- CL = centerline
- CH = chord
- CONC = concrete
- C = covered
- d = deflection
- D = curve delta angle
- E = east
- ESMT = easement
- FC = fence
- FD = found
- HW = headwall
- IPF = iron pin found
- IPF* = iron pin found w/KBW cap
- IPS = iron pin set w/SSI cap
- L = length
- MEAS = measured
- MIN = minimum
- MH = manhole
- N = north
- OH = overhang
- P = porch
- PC = point of curve
- POB = point of beginning
- POC = point of commencement
- PT = point of tangent
- PVMT = pavement
- R = radius
- REC = recorded
- RES = residence
- ROW = right of way
- S = south
- SAN = sanitary
- STM = storm
- SWR = sewer
- SYN = synthetic
- UTIL = utility
- U = uncovered
- W = west
- YI = yard inlet
- ° = degrees
- ' = minutes, in
- " = bearings or angles seconds, in
- ' = bearings or angles feet, in distance
- AC = acres
- ± = more or less, or plus or minus

No title search of the public records has been performed by this firm and land shown hereon was not abstracted for easements and/or right-of-way, recorded or unrecorded.

4082

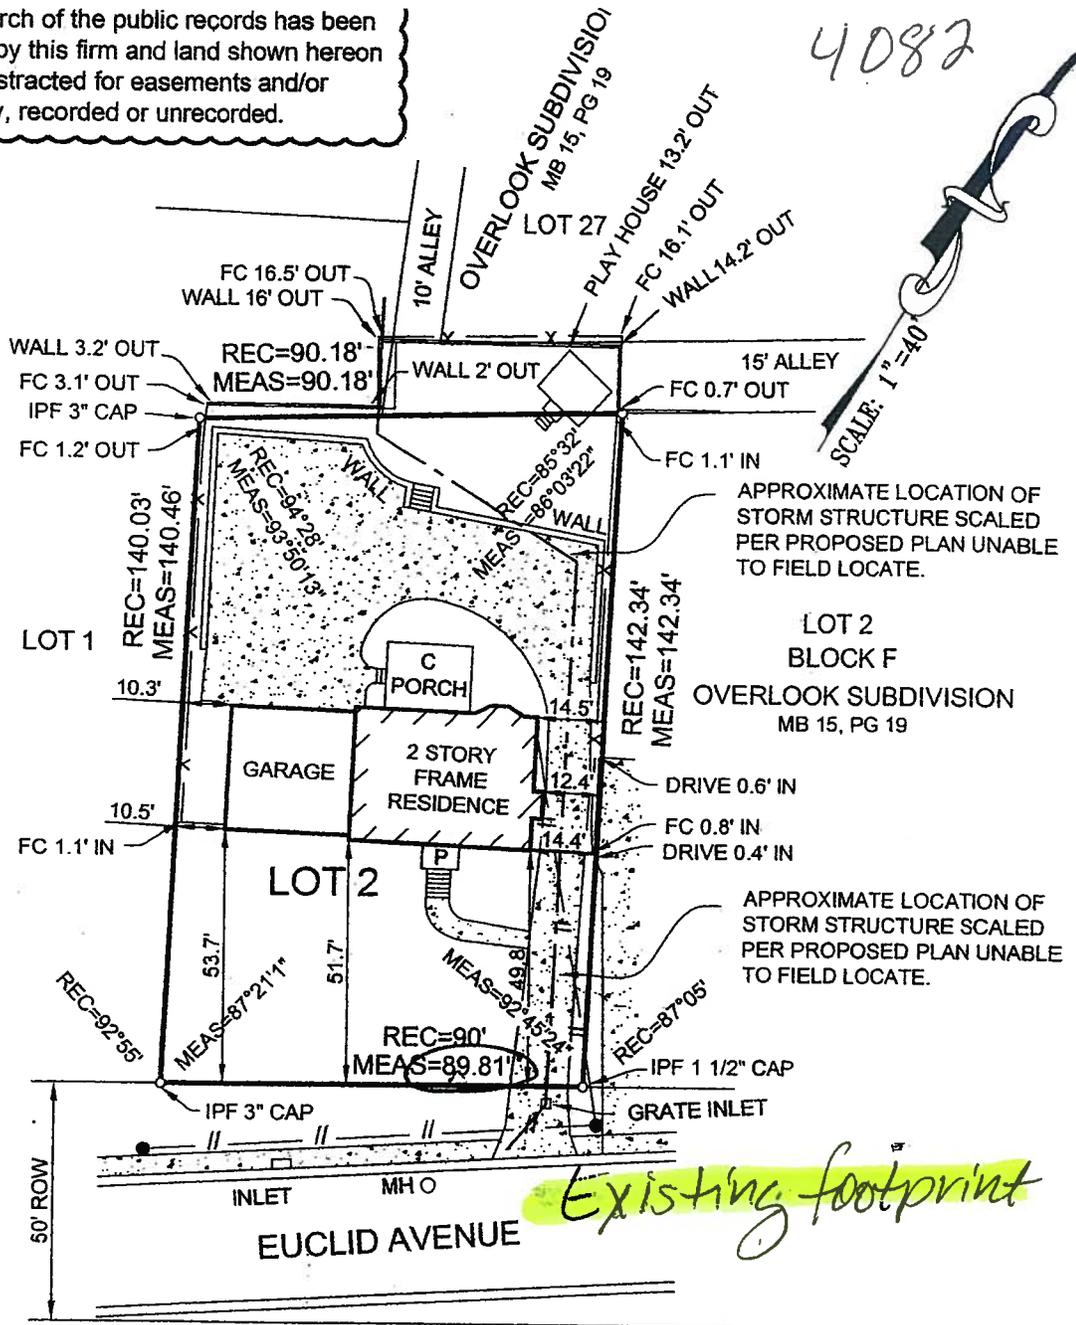

STATE OF ALABAMA
SHELBY COUNTY

I, David B. Entrekin, a registered Land Surveyor, certify that I have surveyed Lot 2, FIRST SECTOR BENTLEY HILLS 6TH ADDITION as recorded in Map Book 36, Page 61 in the Office of the Judge of Probate, Jefferson County, Alabama; that all parts of this survey and drawing have been completed in accordance with the current requirements of the Standards of Practice for Surveying in the State of Alabama to the best of my knowledge, information, and belief; that I have consulted the Federal Insurance Administration "Flood Hazard Boundary Map" and found that this property is located in flood Zone X unshaded according to F.I.R.M. community panel number 010128 0394 G, City of Mountain Brook, Jefferson County, Alabama; dated: 9-29-2006 that the correct address is as follows: 612 Euclid Avenue according to my survey of October 5, 2010. Survey is not valid unless it is sealed with embossed seal or stamped in red.

Order No. 100602
Purchaser: Johnson
Type of Survey: Asbuilt

SURVEYING SOLUTIONS, INC.
5511 HIGHWAY 280 EAST SUITE 314
BIRMINGHAM, AL 35242
PHONE: 991-8965

David B. Entrekin
David B. Entrekin, Reg. L.S. #30345

10-11-2010
Date of Signature

