


4087

Block 5

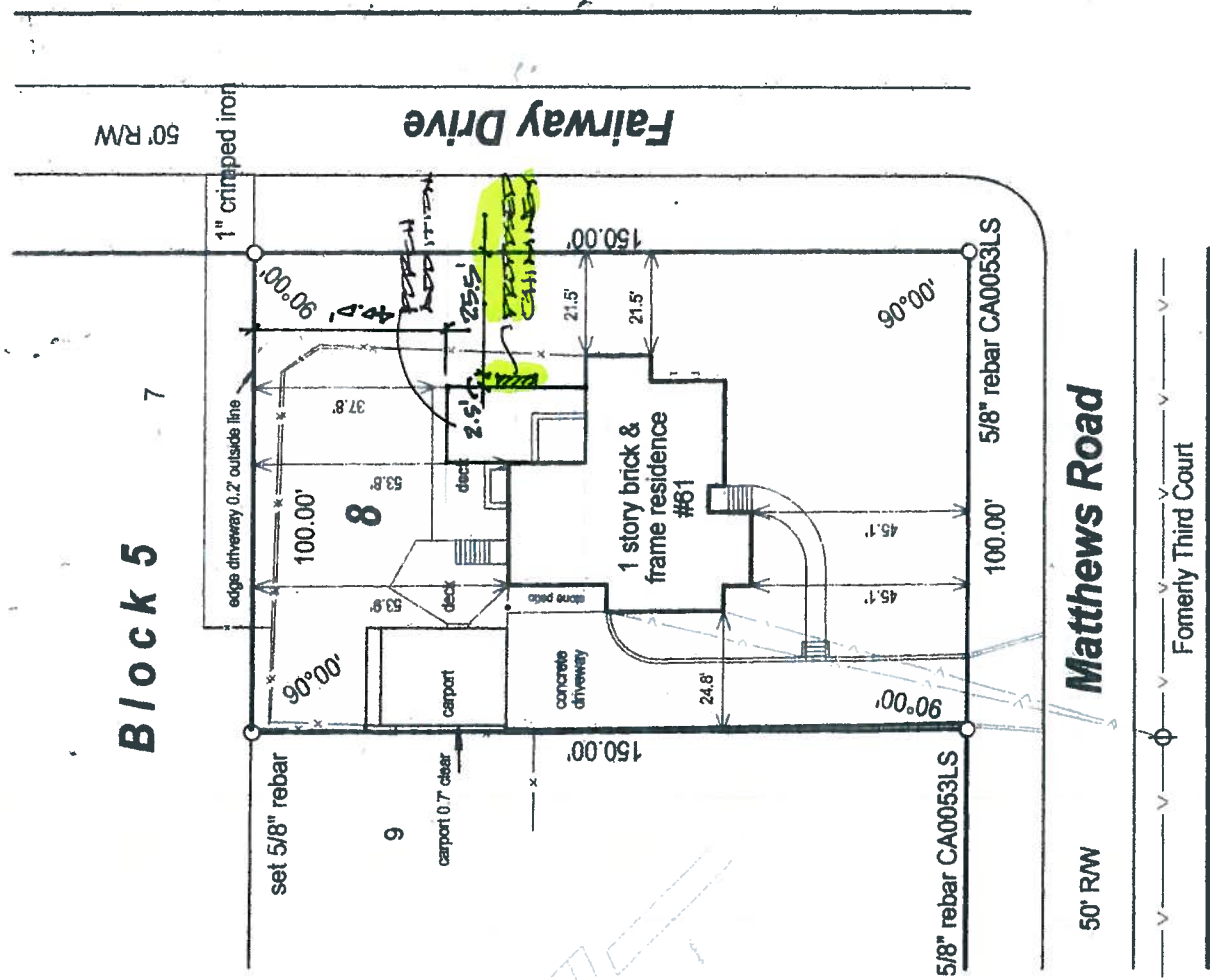

STATE OF ALABAMA
JEFFERSON COUNTY


I, Steven H. Gilbert, a Professional Land Surveyor in the State of Alabama, hereby certify to the parties listed below that the following is a true and correct copy of a map or plat of a survey made by me of the following described property:

Lot 8, Block 5, Map of Country Club Gardens, as recorded in Map Book 15, Page 10, in the Probate Office of Jefferson County, Alabama.

The sole purpose of this survey is for use as a Mortgage Loan Certificate Survey or Mortgage Loan Closing Survey showing the existence or non-existence of encroachments into or out of said property. I further certify that the building(s) now erected on said property are within the boundaries of same except as may be shown; that there are no encroachments from adjacent property except as shown; that there are no Rights-of-way, Easements, or joint driveways over or across said land visible on the surface, except as shown; that there are no utility poles, guy wires, lines, structures, or supports therefor (excepting those that serve the premises only), except as shown; that I have consulted the Federal Insurance Administration Flood Hazard Boundary maps and found this property IS NOT located in a Flood Hazard Area; and that all parts of this survey and drawing have been completed in accordance with the requirements of the Standards of Practice for Land Surveying in the State of Alabama, to the best of my knowledge, information, and belief.

This survey is invalid without an original signature.

ADDITIONS OR DELETIONS TO SURVEY DRAWINGS BY ANY OTHER PERSON(S) THAN THE SIGNING PARTY OR PARTIES ARE PROHIBITED WITHOUT WRITTEN CONSENT OF THE SIGNING PARTY OR PARTIES.

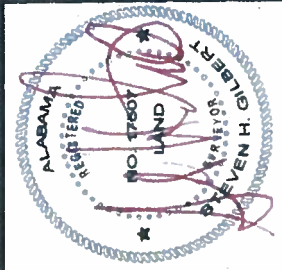

Project No. 20120407
Carey & Patty Gilbert
As built Survey
61 Matthews Road
Mountain Brook, Alabama
April 14, 2012

Scale 1" = 40 feet
SOUTHEASTERN SURVEYORS, INC
Steven H. Gilbert, P.L.S.
Alabama Reg. Land Surveyor No.
17507
5160 Scenic View Drive
Birmingham, Alabama 35210
(205) 966-7125
Fax(205) 966-7146

Legend

Iron boundary marker	utility pole
open pipe find	fire hydr.
power box	tree
capped pipe find.	TV/tel. box
water valve	offset cross
guy anchor	commencing point
5/8" rebar set 17507	gas valve
Drain Manhole	Sanitary manhole
Tel. Manhole	Sign
measured dim.	platted dim.
water meter	gas meter
power meter	Sign
chain link fence	
gas line	
water line	
overhead utility line	
wire fences	
wood fences	
center line	