


**LEGEND:**

- ASPH = asphalt
- BRG = bearing
- BLDG = building
- CALC = calculated
- CAP = capped iron
- CL = centerline
- CH = chord
- CONC = concrete
- C = covered
- d = deflection
- D = curve delta angle
- E = east
- ESMT = easement
- FC = fence
- FD = found
- HW = headwall
- IPF = iron pin found
- IPF\* = iron pin found w/KBW cap
- IPS = iron pin set w/SSI cap
- L = length
- MEAS = measured
- MIN = minimum
- MH = manhole
- N = north
- OH = overhang
- P = porch
- PC = point of curve
- POB = point of beginning
- POC = point of commencement
- PT = point of tangent
- PVMT = pavement
- R = radius
- REC = recorded
- RES = residence
- ROW = right of way
- S = south
- SAN = sanitary
- STM = storm
- SWR = sewer
- SYN = synthetic
- UTIL = utility
- U = uncovered
- W = west
- YI = yard inlet
- ° = degrees
- ' = minutes, in
- " = bearings or angles seconds, in
- ' = bearings or angles feet, in distance
- AC = acres
- ± = more or less, or plus or minus

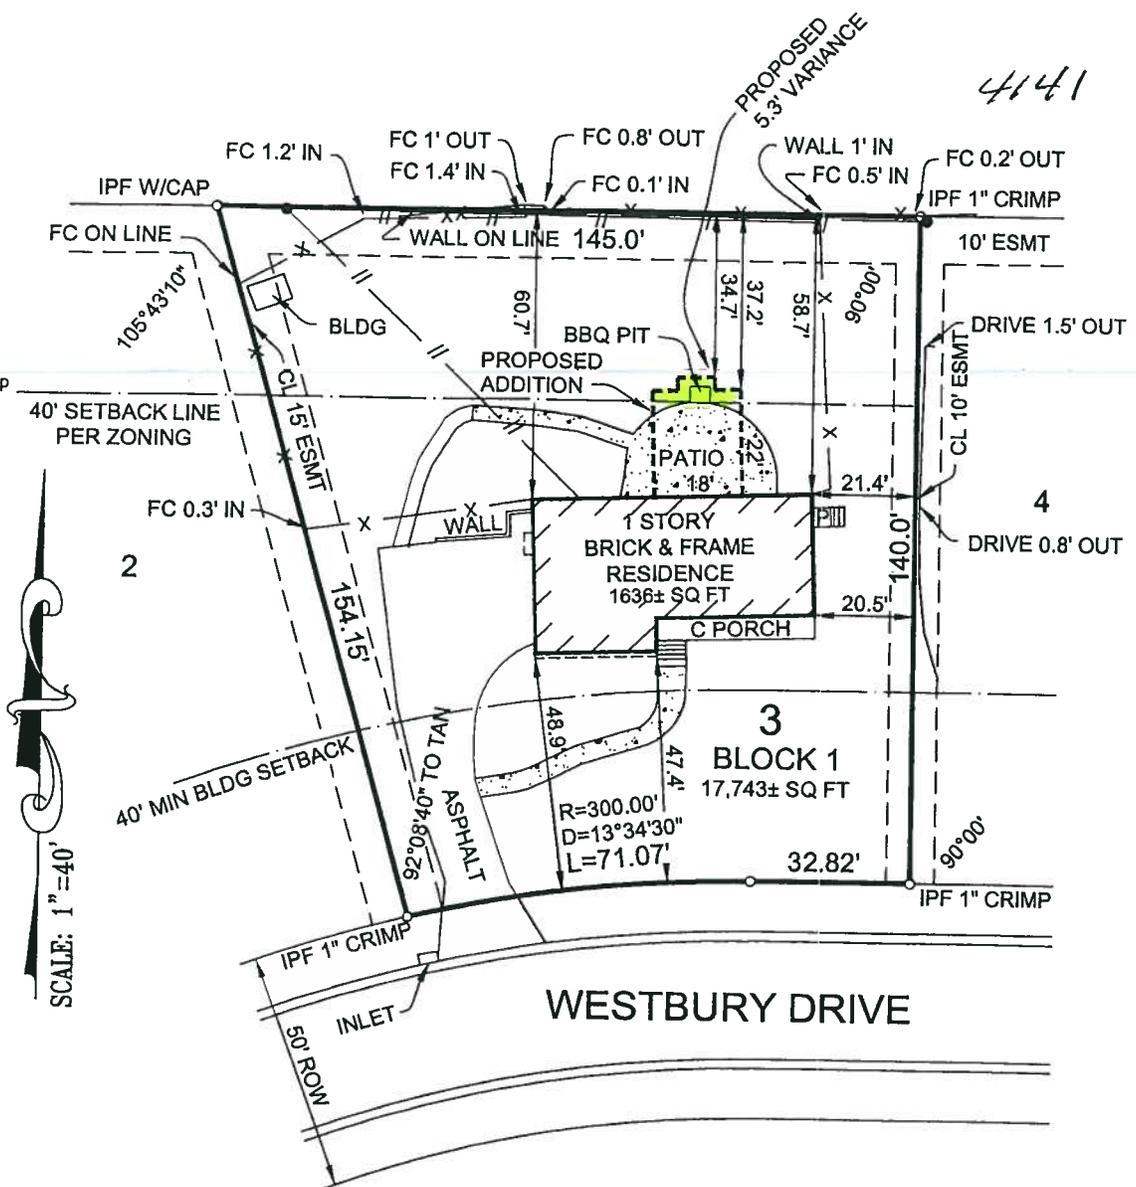

4141

STATE OF ALABAMA  
SHELBY COUNTY

I, Carl Daniel Moore, a registered Land Surveyor, certify that I have surveyed Lot 3, Block 1, CRESTRIDGE ADDITION TO MOUNTAIN BROOK CREST ESTATES 1ST SECTOR as recorded in Map Book 57, Page 71 in the Office of the Judge of Probate, Jefferson County, Alabama; that all parts of this survey and drawing have been completed in accordance with the current requirements of the Standards of Practice for Surveying in the State of Alabama to the best of my knowledge, information, and belief; that the correct address is as follows: 3616 Westbury Drive according to my survey of August 15, 2014. Survey is not valid unless it is sealed with embossed seal or stamped in red. Revised September 4, 2014 added rear setback line, rear readoffs and square footage of lot. Revised September 11, 2014 to show proposed addition and 5.3' variance.

SURVEYING SOLUTIONS, INC.  
2232 CAHABA VALLEY DRIVE SUITE M  
BIRMINGHAM, AL 35242  
PHONE: 205-991-8965

*Carl Daniel Moore*  
Carl Daniel Moore, Reg. L.S. #12159

9-11-14

Date of Signature



Order No. 310982  
Purchaser: Hutchison  
Type of Survey: Asbuilt