


4065

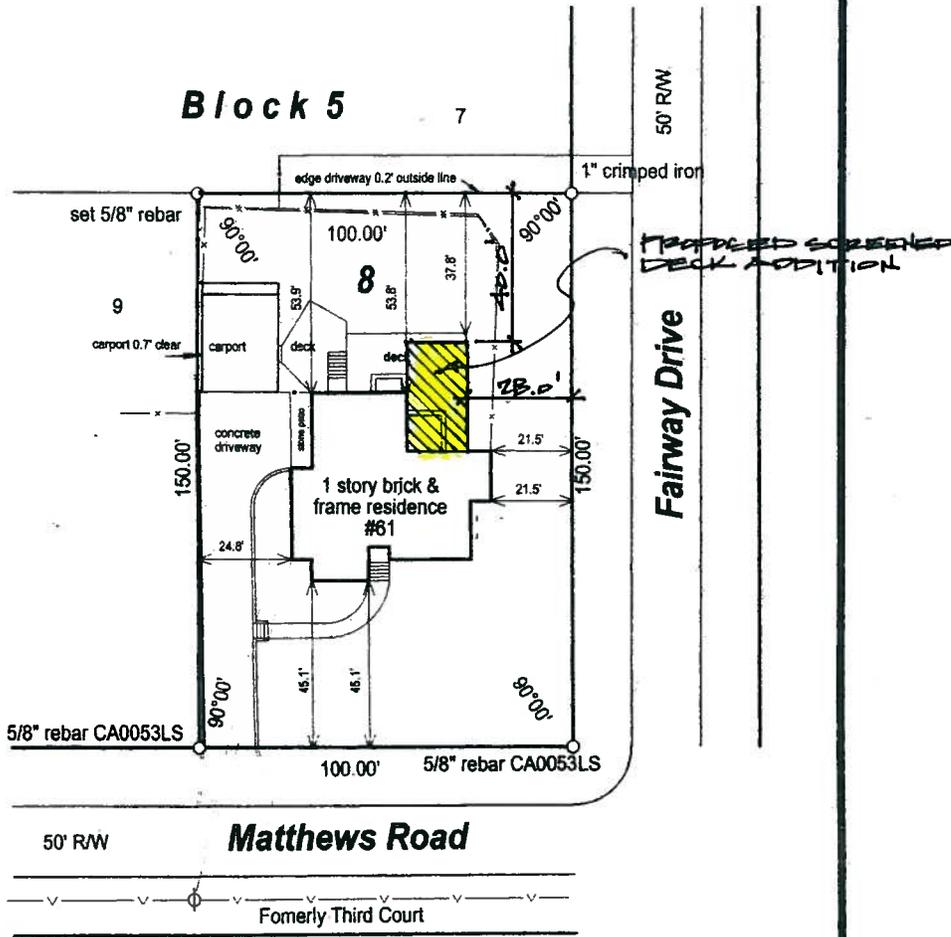

Scale 1" = 40'

STATE OF ALABAMA
JEFFERSON COUNTY

I, Steven H. Gilbert, a Professional Land Surveyor in the State of Alabama, hereby certify to the parties listed below that the following is a true and correct copy of a map or plat of a survey made by me of the following described property:

Lot 8, Block 5, Map of Country Club Gardens, as recorded in Map Book 15, Page 10, in the Probate Office of Jefferson County, Alabama.

The sole purpose of this survey is for use as a Mortgage Loan Certificate Survey or Mortgage Loan Closing Survey showing the existence or non-existence of encroachments into or out of said property. I further certify that the building(s) now erected on said property are within the boundaries of same except as may be shown; that there are no encroachments from adjacent property except as shown; that there are no Rights-of-way, Easements, or joint driveways over or across said land visible on the surface, except as shown; that there are no utility poles, guy wires, lines, structures, or supports therefor (excepting those that serve the premises only), except as shown; that I have consulted the Federal Insurance Administration Flood Hazard Boundary maps and found this property IS NOT located in a Flood Hazard Area; and that all parts of this survey and drawing have been completed in accordance with the requirements of the Standards of Practice for Land Surveying in the State of Alabama, to the best of my knowledge, information, and belief.

This survey is invalid without an original signature.

ADDITIONS OR DELETIONS TO SURVEY DRAWINGS BY ANY OTHER PERSON(S) THAN THE SIGNING PARTY OR PARTIES ARE PROHIBITED WITHOUT WRITTEN CONSENT OF THE SIGNING PARTY OR PARTIES.

Legend

○ iron boundary marker	⊙ utility pole
⊕ open pipe find.	⊙ fire hyd.
⊞ power box	⊕ tree
⊕ capped pipe find.	⊞ TV/tel. box
⊕ water valve	⊕ offset cross
⊕ guy anchor	⊕ commencing point
PS 5/8" rebar est 17507	⊕ gas valve
⊕ Drain Manhole	⊕ Sanitary manhole
⊕ Tel. Manhole	⊕ Sign
⊕ measured dim.	⊕ platted dim.
⊕ water meter	⊕ gas meter
⊕ power meter	⊕ Sign
—•— chain link fence	
—gas— gas line	
—W— water line	
—overhead— overhead utility line	
—wire— wire fence	
—/— wood fence	
—center— center line	

Project No. 20120407
Carey & Patty Gilbert
As built Survey
61 Matthews Road
Mountain Brook, Alabama
April 14, 2012



Scale 1" = 40 feet
SOUTHEASTERN SURVEYORS, INC
Steven H. Gilbert, P.L.S.
Alabama Reg. Land Surveyor No.
17507
5160 Scenic View Drive
Birmingham, Alabama 35210
(205) 956-7125
Fax(205) 956-7146

4065