LEGEND

IPF	IRON PIN FOUND
IPS	IRON PIN SET
	CONCRETE MONUMENT
R.O.W.	RIGHT OF WAY
	UTILITY POLE w/GUY
OHP	OVERHEAD POWER
	WATER METER
	IRRIGATION VALVE
X X X	FENCE
	WALL
	GRAVEL
	CONCRETE
	ASPHALT
(M)	MEASURED
(D)	DEED BOOK 6783 PG. 489 AS RECORDED IN THE OFFICE OF THE JUDGE OF PROBATE, JEFFERSON COUNTY, ALABAMA.
(R)	PLAT BOOK 7, PAGE 105, AS RECORDED IN THE OFFICE OF THE JUDGE OF PROBATE, JEFFERSON COUNTY, ALABAMA.

0' 30' 60' 90'

SCALE IN FEET

Note: Right of way shown hereon was taken from maps provided by Alabama Department of Transportation.

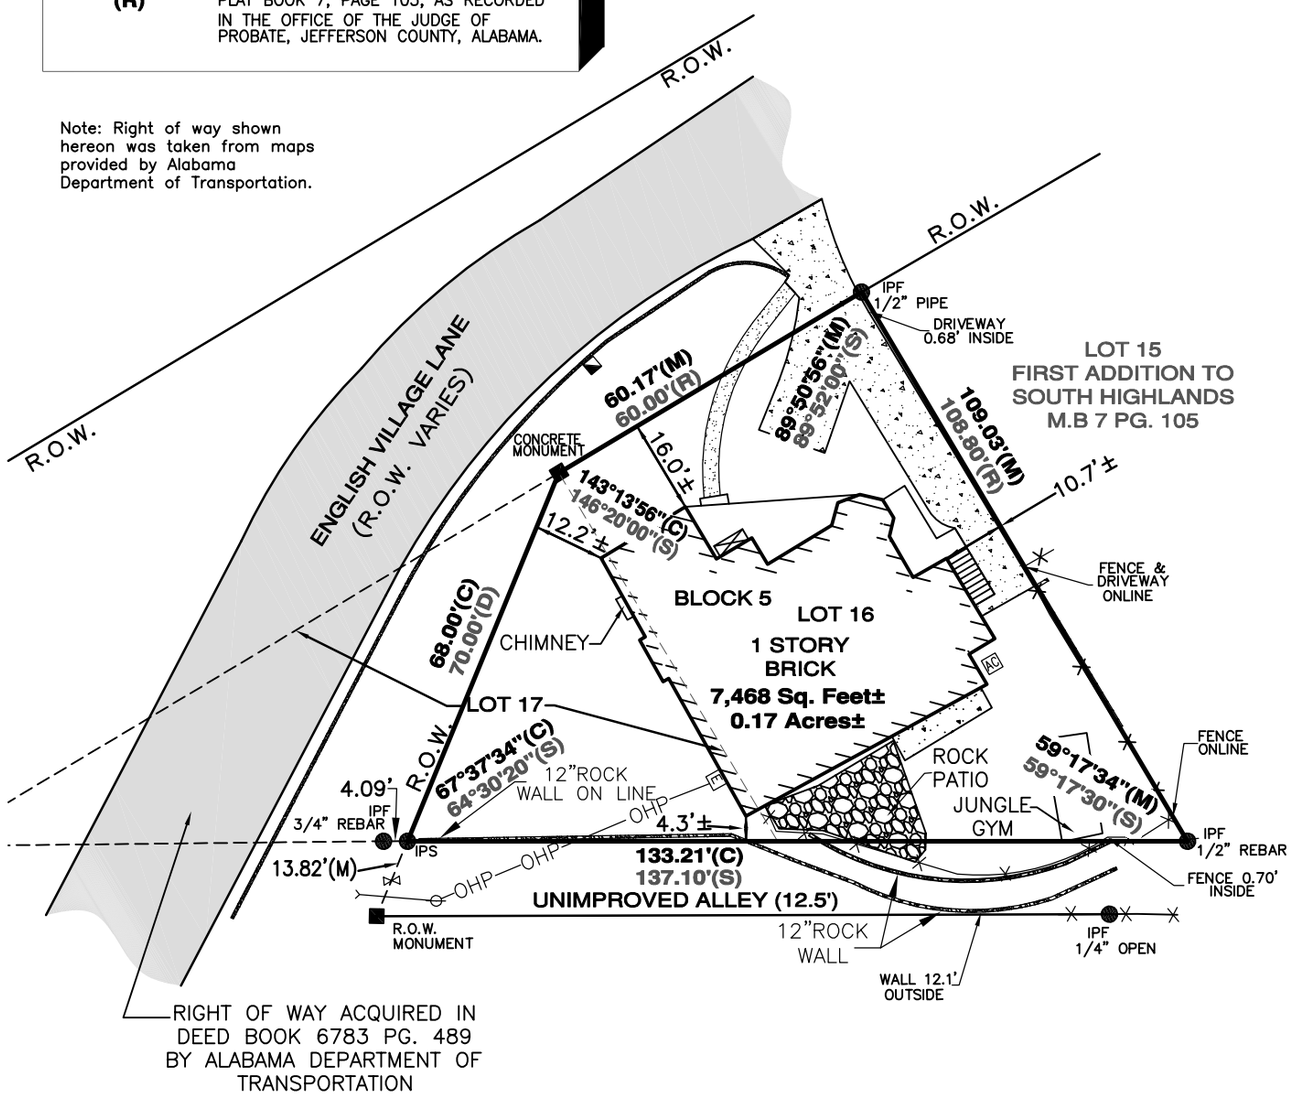

AS-BUILT SURVEY

OWNER: Clay Wilson
STREET ADDRESS:
2031 English Village Lane

Note: North arrow shown hereon is based on magnetic North.

No title policy provided to surveyor. Without said title policy no guarantee can be made by the surveyor as to the location of easements.

STATE OF ALABAMA
JEFFERSON COUNTY

I, Derek S. Meadows, a Registered Professional Land Surveyor do hereby certify that all parts of this survey and drawing have been completed in accordance with the requirements of standards of practice for surveying in the State of Alabama and that this is a true and correct survey, to the best of my knowledge and belief, of Lot 16 & 17 Block 5, First Addition to South Highlands as recorded in Plat Book 7, Page 105 in the Office of the Judge of Probate, Jefferson County, Alabama Birmingham Division. LESS AND EXCEPT that portion of subject property conveyed to the State of Alabama by deed recorded in Deed Volume 6783, Page 489.

ALABAMA REGISTERED No. 29996 PROFESSIONAL LAND SURVEYOR DEREK S. MEADOWS

Date 07/22/2014

Derek S. Meadows, Reg. No. 29996
GONZALEZ – STRENGTH & ASSOC., INC.

Field Book _____, Page ____ Inv. No. _____ Job No. 27663

Property shown hereon does not lie (Zone "X") within the special flood hazard area as indicated on the Federal Insurance Administration Flood Boundary Map 01073C, 0556 H, 03 Sep 2010 Jefferson County, Alabama.

GONZALEZ - STRENGTH & ASSOCIATES, INC.
ENGINEERING, LAND PLANNING, & SURVEYING
2176 PARKWAY LAKE DRIVE
HOOVER, ALABAMA 35209
PHONE: (205) 942-2456
FAX: (205) 942-3033
www.Gonzalez-Strength.com

© Copyright 2002